SO 11472 (Title Plan)

Cpy – 01/01, Pgs – 001, 20/05/04, 14:09

DocID: 11G143871

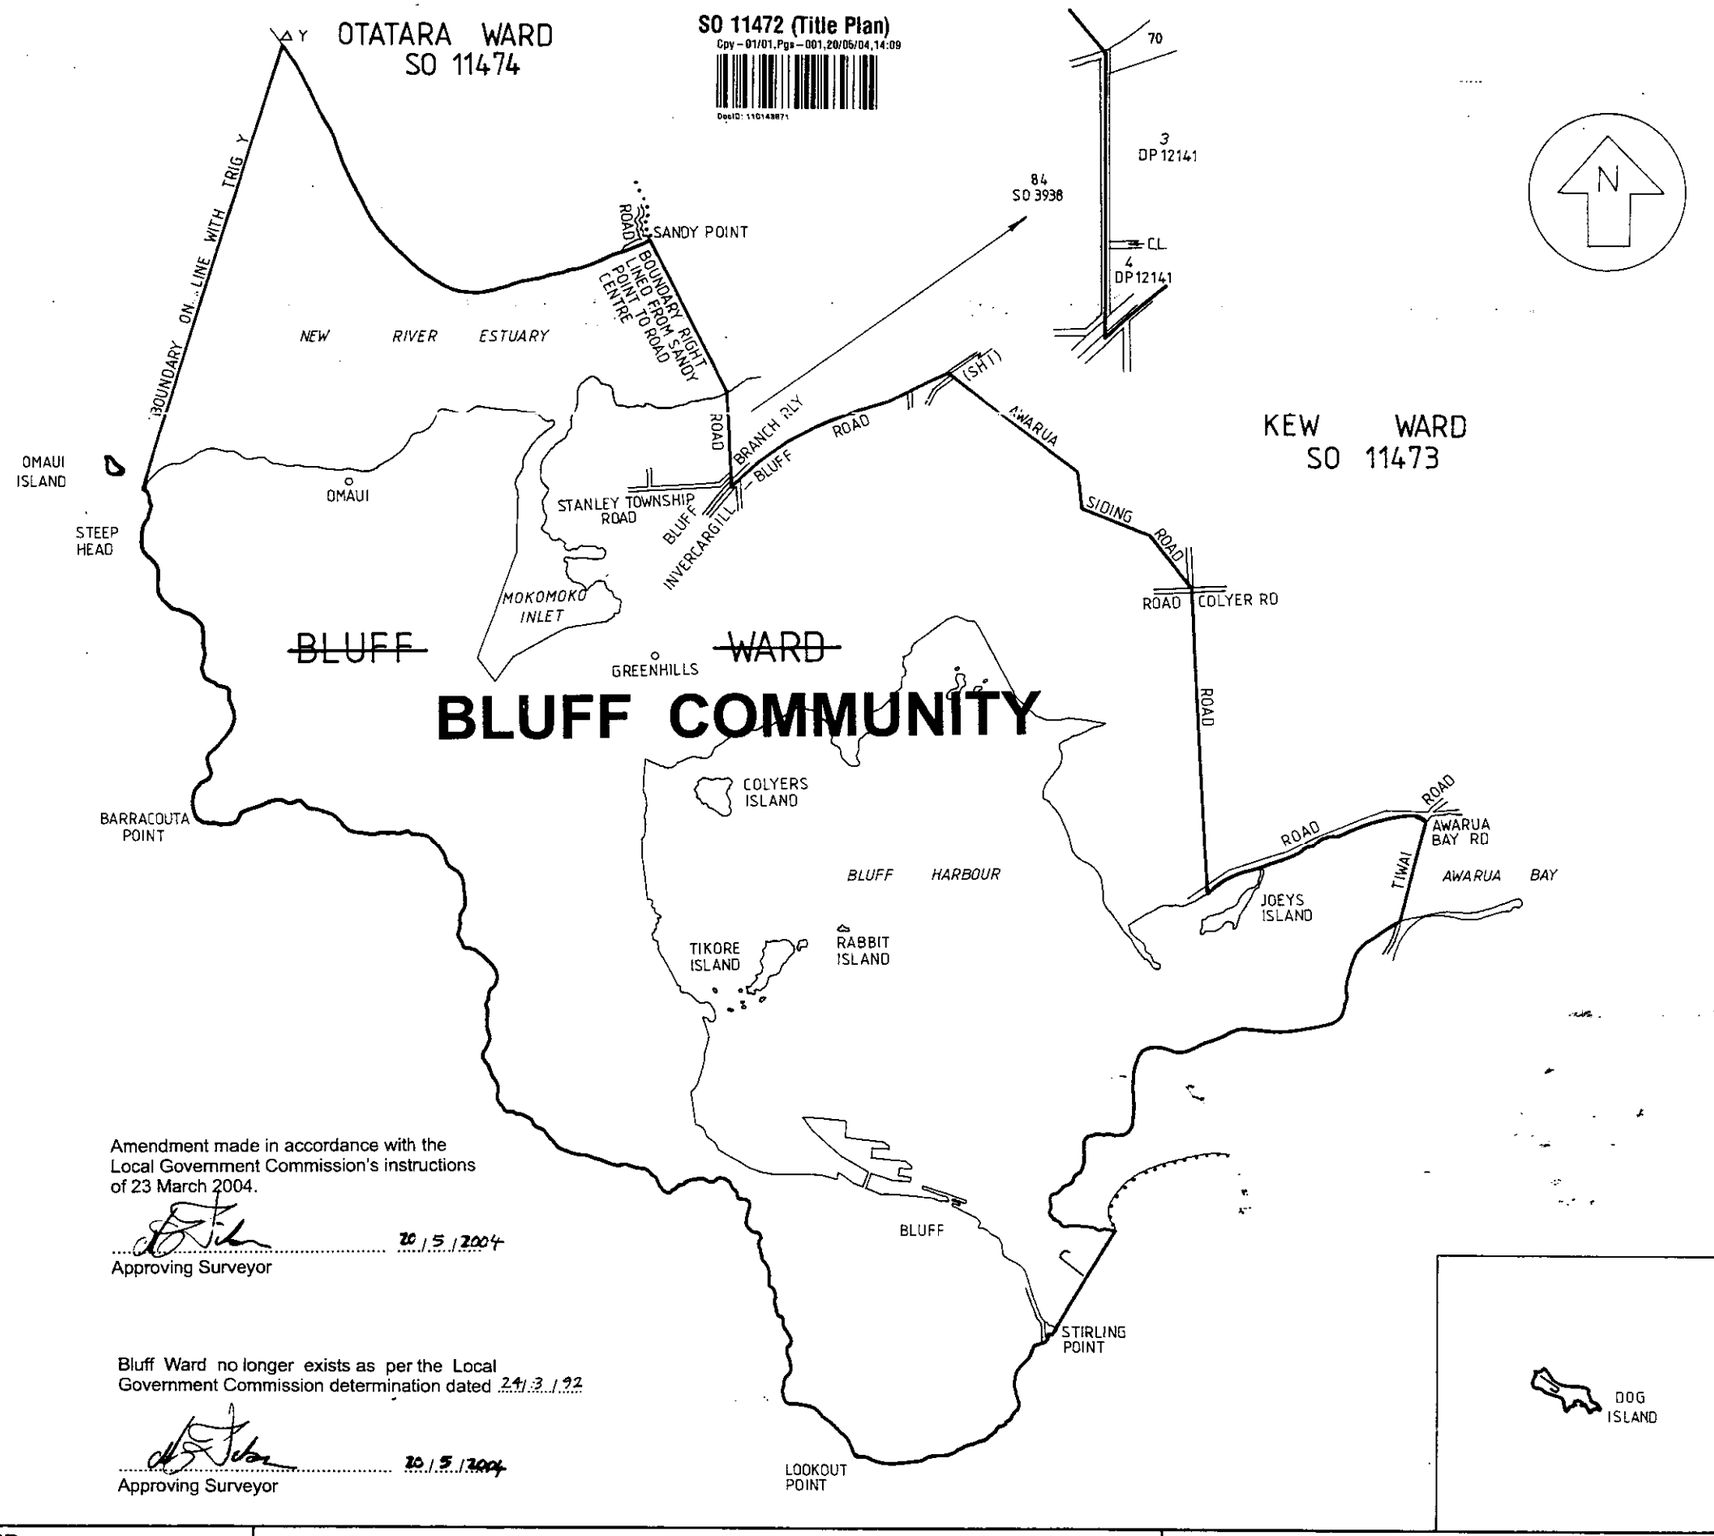


Amendment made in accordance with the Local Government Commission's instructions of 23 March 2004.

20/5/2004

Approving Surveyor

Bluff Ward no longer exists as per the Local Government Commission determination dated 24/3/92

20/5/2004

Approving Surveyor

**Approvals**

**NOTE:**

Where a Boundary is shown along a river or road it follows the middle line of the physical river or legal road unless shown otherwise

All seaward boundaries follow MHWM but cross the mouths of all rivers, streams, inlets, and estuaries unless shown otherwise

..... Adjoining Ward/District Boundary

Invercargill City constituted by Gaz 1990 p 2326

Chief Surveyor

**Total Area**

**Comprised in**

I, .....

*Registered Surveyor and holder of an annual practising certificate (or who may act as a registered surveyor pursuant to section 25 of the Survey Act 1986) hereby certify that this plan has been made from surveys executed by me or under my directions, that both plan and survey are correct and have been made in accordance with the Survey Regulations 1972 or any regulations made in substitution thereof.*

*Dated at ..... this ..... day .....*

*of ..... 19 ..... Signature .....*

*Field Book* *p.* *Traverse Book* *p.*

*Reference Plans*

*Examined* *Correct*

**Approved for Gazette Purposes**

7/6/89 S. Weller Acting Chief Surveyor

**Deposited this** day of 19

District Land Registrar

| | | |
|---|---|---|
| LAND DISTRICT SOUTHLAND<br><br>NZMS 261 Sheet E47 | BLUFF ~~WARD~~ COMMUNITY | TERRITORIAL AUTHORITY INVERCARGILL ~~DISTRICT~~ CITY<br>Prepared by Survey & Land Information<br>Scale 1:50000 Date JUNE 1989 |

| | |
|---|---|
| SOUTHLAND LD | SO 11472 |